

REV.	REVISION DATE	BY
1	8-26-14	T.L.H.

NOTES:



GENERAL NOTES:

- ACCESS TO BUILDING FOR PERSONS IN WHEELCHAIRS IS DESIGNED BY AND FIELD BUILT BY SMM AND SUBJECT TO LOCAL JURISDICTION APPROVAL. THE PRIMARY ENTRANCE AND ALL REQUIRED EXITS MUST BE ACCESSIBLE.
- ALL DOORS SHALL BE OPENABLE FROM THE EGRESS SIDE WITHOUT THE USE OF A KEY, TOOL, SPECIAL KNOWLEDGE OR EFFORT. MANUALLY OPERATED FLUSH BOLTS OR SURFACE BOLTS SHALL NOT BE USED.
- ALL GLAZING WITHIN A 24 INCH ARC OF DOORS, WHOSE BOTTOM EDGE IS LESS THAN 60 INCHES ABOVE THE FLOOR, AND ALL GLAZING IN DOORS SHALL BE SAFETY, TEMPERED OR ACRYLIC PLASTIC SHEET.
- SEE CROSS SECTION FOR ROOF TO WALL AND WALL TO FLOOR CONNECTION REQUIREMENTS.
- PORTABLE FIRE EXTINGUISHER PER NFPA-10 (INSTALLED BY OTHERS ON SITE, AND SUBJECT TO LOCAL JURISDICTION).
- PROVISIONS FOR EXIT DISCHARGE LIGHTING ARE THE RESPONSIBILITY OF THE BUILDING OWNER AND SUBJECT TO LOCAL JURISDICTION APPROVAL WHEN NOT SHOWN ON THE FLOOR PLAN (INCLUDING EMERGENCY LIGHTING, WHEN REQUIRED).
- WHEN LOW SIDES OF ROOF PROVIDE LESS THAN 6" OF OVERHANG, GUTTERS AND DOWN SPOUTS SHALL BE SITE INSTALLED, DESIGNED BY SMM, SUBJECT TO LOCAL JURISDICTION APPROVAL.
- IN WIND-BORNE DEBRIS REGIONS, EXTERIOR GLAZING SHALL BE IMPACT RESISTANT OR PROTECTED WITH AN IMPACT RESISTANT COVERING MEETING THE REQUIREMENTS OF AN APPROVED IMPACT RESISTANT STANDARD, OR ASTM F1586. WIND-BORNE DEBRIS REGIONS ARE DESIGNATED IN SECTION 1609 OF THE IBC.
- WINDOWS AND DOORS MUST BE CERTIFIED FOR COMPLIANCE WITH THE WIND DESIGN PRESSURE FOR COMPONENTS AND CLADDING.
- STRUCTURAL DETAILS NOT INCLUDED IN THIS PLAN SET ARE TO BE CONSTRUCTED ACCORDING TO THE MANUFACTURERS STATE APPROVED BUILDING SYSTEM MANUAL.

NOTE:

FLOOR SYSTEM DESIGN FOR 15'-0" WIDE MODULES REQUIRES PERIMETER PIERS AT 8 FEET O.C., SEE FOUNDATION PLAN FOR PIER REQUIREMENTS.

ELECTRICAL NOTES:

- ALL CIRCUITS AND EQUIPMENT SHALL BE GROUNDED IN ACCORDANCE WITH THE APPROPRIATE ARTICLES OF THE NATIONAL ELECTRICAL CODE (NEC).
- WHEN LIGHT FIXTURES ARE INSTALLED IN CLOSETS THEY SHALL BE SURFACE MOUNTED OR RECESSED. INCANDESCENT FIXTURES SHALL HAVE COMPLETELY ENCLOSED LAMPS. SURFACE MOUNTED INCANDESCENT FIXTURES SHALL HAVE A MINIMUM CLEARANCE OF 12 INCHES AND ALL OTHER FIXTURES SHALL HAVE A MINIMUM CLEARANCE OF 8 INCHES FROM "STORAGE AREA" AS DEFINED BY NEC 410-80.
- WHEN WATER HEATERS ARE INSTALLED THEY SHALL BE PROVIDED WITH HEAVILY ACCESSIBLE DISCONNECTS ADJACENT TO THE WATER HEATERS SERVED. THE BRANCH CIRCUIT SWITCH OR CIRCUIT BREAKER SHALL BE PERMITTED TO SERVE AS THE DISCONNECTING MEANS ONLY WHERE THE SWITCH OR CIRCUIT BREAKER IS WITHIN SIGHT FROM THE WATER HEATER OR IS CAPABLE OF BEING LOCKED IN THE OPEN POSITION.
- HVAC EQUIPMENT SHALL BE PROVIDED WITH HEAVILY ACCESSIBLE DISCONNECTS ADJACENT TO THE EQUIPMENT SERVED. A UNIT SWITCH WITH A MARKED "OFF" POSITION THAT IS A PART OF THE HVAC EQUIPMENT AND DISCONNECTS ALL UNGROUNDED CONDUCTORS SHALL BE PERMITTED AS THE DISCONNECTING MEANS WHERE OTHER DISCONNECTING MEANS ARE ALSO PROVIDED BY A READY ACCESSIBLE CIRCUIT BREAKER.
- PRIOR TO ENERGIZING THE ELECTRICAL SYSTEM THE INTERRUPTING RATING OF THE MAIN BREAKER MUST BE DESIGNED AND VERIFIED AS BEING IN COMPLIANCE WITH SECTION 110-9 OF THE NEC BY LOCAL ELECTRICAL CONSULTANT.
- THE MAIN ELECTRICAL PANEL AND FEEDERS ARE DESIGNED BY OTHERS. SITE INSTALLED AND SUBJECT TO LOCAL JURISDICTION APPROVAL.
- ALL CIRCUITS CROSSING OVER MODULE MATING LINES SHALL BE SITE CONNECTED WITH APPROVED ACCESSIBLE JUNCTION BOXES, OR CABLE CONNECTORS.
- ALL RECEPTACLES INSTALLED IN WET LOCATIONS (EXTERIOR) SHALL BE IN WEATHER PROOF (WP) ENCLOSURES. THE INTEGRITY OF WHICH IS NOT AFFECTED WHEN AN ATTACHMENT PLUG CAP IS INSERTED OR REMOVED. THE RECEPT ITSELF SHALL ALSO BE LISTED FOR DAMP AND WET LOCATIONS AS PER 2011 NEC.
- EXTERIOR LIGHTS NOT INTENDED FOR 24 HOUR USE SHALL BE CONNECTED TO A PHOTOCELL OR TIMER.
- ALL BRANCH CIRCUIT WIRING IN EXAM ROOMS AND PATIENT CARE AREAS MUST INCLUDE AN INSULATED COPPER EQUIPMENT GROUNDING CONDUCTOR AND WILL BE RUN IN EMT.

PLUMBING NOTES:

- TOILETS SHALL BE ELONGATED WITH NONABSORBENT OPEN FRONT SEATS.
- REST ROOM WALLS SHALL BE COVERED WITH NONABSORBENT MATERIAL TO A MINIMUM HEIGHT OF 48 INCHES 4 FT.
- FLOORS SHALL HAVE A SMOOTH, HARD, NONABSORBENT SURFACE THAT EXTENDS UPWARD ONTO THE WALLS AT LEAST 6 INCHES.
- TEMPERATURE ACTUATED MIXING VALVES WHICH ARE INSTALLED TO REDUCE WATER TEMPERATURE TO DEFINE LIMITS SHALL COMPLY WITH ASSE 1017 FOR AIR RETURN AND/OR AS NOTED ON FLOOR PLAN.
- INTERIOR DOORS SHALL BE UNDERCUT 1.5 INCHES ABOVE FINISHED FLOOR FOR AIR RETURN AND/OR AS NOTED ON FLOOR PLAN.
- HVAC EQUIPMENT SHALL BE EQUIPPED W/OUTSIDE FRESH AIR INTAKES PROVIDING 5 CFM PER OCCUPANT AND 0.06 AREA AIRFLOW RATE PER INCH SECTION 403.
- EXHAUST FANS SHALL PROVIDE A MINIMUM OF 70 CFM FOR EACH WATER CLOSET AND URINAL AND VENTILATE TO EXTERIOR OF BUILDING.
- WATER SUPPLY LINES SHALL BE CPVC, OR COPPER, AND SHALL BE INSTALLED IN ACCORDANCE WITH THE MANUFACTURERS LIMITATIONS AND INSTRUCTIONS.
- WATER CLOSETS ARE TANK TYPE AND URINALS ARE FLUSH TANK TYPE UNLESS OTHERWISE SPECIFIED.
- BUILDING DRAIN AND CLEANOUTS ARE DESIGNED AND SITE INSTALLED BY OTHERS, SUBJECT TO LOCAL JURISDICTION APPROVAL.
- SHOWERS SHALL BE CONTROLLED BY AN APPROVED MIXING VALVE WITH A MAXIMUM WATER OUTLET TEMPERATURE OF 120°F (48.9°C).
- THERMAL EXPANSION DEVICE, IF REQUIRED BY WATER HEATER INSTALLED, AND IF NOT SHOWN ON PLUMBING PLAN, IS DESIGNED AND SITE INSTALLED BY OTHERS, SUBJECT TO LOCAL APPROVAL.
- WATER PIPES INSTALLED IN A WALL EXPOSED TO THE EXTERIOR SHALL BE LOCATED ON THE HEATED SIDE OF THE WALL INSULATION. WATER PIPING INSTALLED IN AN UNCONDITIONED ATTIC SHALL BE INSULATED WITH AN INSULATION OF R-5.5 MINIMUM.
- PIPING IN UNCONDITIONED SPACES MUST BE PROTECTED WITH INSULATION HAVING A MINIMUM R FACTOR OF 6.0 IN ACCORDANCE WITH SECTION 308.6.
- THIS BUILDING SHALL BE CONNECTED TO A PUBLIC WATER SUPPLY AND SEWER SYSTEM IF THESE ARE AVAILABLE.
- THE MAXIMUM ALLOWABLE AIR LEAKAGE RATE FOR WINDOWS IS 0.3 CFM PER SQUARE FEET OF WINDOW AREA.
- THE MAXIMUM ALLOWABLE AIR LEAKAGE RATE FOR EXTERIOR DOORS IS 0.5 CFM PER SQUARE FEET OF DOOR AREA.

MECHANICAL NOTES:

- ALL SUPPLY AIR REGISTERS SHALL BE 10 INCHES x 10 INCHES ADJUSTABLE WITH 10 INCHES x 20 INCHES (INSIDE) OVERHEAD FIBERGLASS DUCT, UNLESS OTHERWISE SPECIFIED. DUCTS IN UNCONDITIONED SPACES SHALL HAVE R-5 MINIMUM INSULATION.
- INTERIOR DOORS SHALL BE UNDERCUT 1.5 INCHES ABOVE FINISHED FLOOR FOR AIR RETURN AND/OR AS NOTED ON FLOOR PLAN.
- HVAC EQUIPMENT SHALL BE EQUIPPED W/OUTSIDE FRESH AIR INTAKES PROVIDING 5 CFM PER OCCUPANT AND 0.06 AREA AIRFLOW RATE PER INCH SECTION 403.
- EXHAUST FANS SHALL PROVIDE A MINIMUM OF 70 CFM FOR EACH WATER CLOSET AND URINAL AND VENTILATE TO EXTERIOR OF BUILDING.

STRUCTURAL LOAD LIMITATIONS

BUILDING RISK CATEGORY: II

- FLOOR LIVE LOAD:
- A. 50 PSF
 - B. 2000 LB. CONCENTRATED LOAD OVER 30 INCH x 30 INCH AREA LOCATED ANYWHERE ON FLOOR

- ROOF LIVE LOAD:
- A. 20 PSF

ROOF SNOW LOAD:

- A. $P_g = 16$ PSF GROUND SNOW LOAD
- B. $P_f = 12.3$ PSF FLAT ROOF SNOW LOAD
- C. $C_e = 1.1$ SNOW EXPOSURE FACTOR
- D. $I_s = 1.0$ SNOW IMPORTANCE FACTOR
- E. $C_t = 1.0$ SNOW THERMAL FACTOR

WIND LOAD:

- A. 130 MPH MIT WIND SPEED
- B. 100 MPH MIT WIND SPEED
- C. $I_w = 1.0$ WIND IMPORTANCE FACTOR
- D. $C_e = 0.8$ WIND EXPOSURE CATEGORY
- E. $G_Cp = 0.18$ INTERNAL PRESSURE COEFFICIENT

Pr: ZONE 4: 24.0 PSF

Zone 5: 29.5 PSF

Pf: ZONE 1: 22.1 PSF

Zone 2: 37.0 PSF

Zone 3: 50.0 PSF

G. THIS BUILDING IS NOT DESIGNED FOR PLACEMENT ON THE UPPER HALF OF A HILL OR ESCARPMENT EXCEEDING 15 FEET IN HEIGHT.

SEISMIC LOAD:

- A. $I_e = 1.0$ SEISMIC IMPORTANCE FACTOR
- B. D. SITE CLASS
- C. A13 SEISMIC FORCE RESISTING SYSTEM
- D. SEISMIC DESIGN CATEGORY
- E. EQUIVALENT LATERAL FORCE ANALYSIS PROCEDURE
- F. $S_{DS} = 0.9$ MAPPED SPECTRAL RESPONSE COEFF.
- G. $S_1 = 0.25$ MAPPED SPECTRAL RESPONSE COEFF.
- H. $S_{DS} = 0.66$ SPECTRAL RESPONSE COEFFICIENT
- I. $S_1 = 0.32$ SPECTRAL RESPONSE COEFFICIENT
- J. $V = 35822$ LB DESIGN BASE SHEAR
- K. $R = 6.5$ RESPONSE MODIFICATION COEFFICIENT
- L. $C_s = 1.0$ SEISMIC RESPONSE COEFFICIENT

FLOOD LOAD:

THIS BUILDING IS NOT DESIGNED TO BE LOCATED IN A FLOOD HAZARD AREA.

COMPLIANCE WITH LOCAL REQUIREMENTS

SEE 110-2-2-403. ALL INDUSTRIAL BUILDINGS BEARING AN INSIGNA OF APPROVAL ISSUED BY THE COMMISSIONER PURSUANT TO THESE RULES SHALL BE HELD TO COMPLY WITH THE REQUIREMENTS OF ALL ORDINANCES OR REGULATIONS ENACTED BY ANY LOCAL GOVERNMENT WHICH ARE APPLICABLE. THE MANUFACTURER AND INSTALLATION OF SUCH BUILDINGS, THE DETERMINATION BY THE COMMISSIONER OF THE SCOPE OF SUCH APPROVAL IS FINAL.

ACCESSIBILITY NOTES:

- THE INTERNATIONAL SYMBOL OF ACCESSIBILITY SIGN SHALL BE DISPLAYED AT ALL ACCESSIBLE RESTROOM FACILITIES AND AT ACCESSIBLE BUILDING ENTRANCES UNLESS ALL ENTRANCES ARE ACCESSIBLE. INACCESSIBLE ENTRANCES SHALL HAVE DIRECTIONAL SIGNS INDICATING THE ROUTE TO THE NEAREST ACCESSIBLE ENTRANCE.
- ACCESSIBLE DRINKING FOUNTAINS SHALL HAVE A SPOUT HEIGHT NO HIGHER THAN 36 INCHES ABOVE THE FLOOR AND EDGE OF BASIN NO HIGHER THAN 34 INCHES ABOVE THE FLOOR FOR INDIVIDUALS IN WHEELCHAIRS. ADDITIONALLY, DRINKING WATER PROVISIONS SHALL BE MADE FOR INDIVIDUALS WHO HAVE DIFFICULTY BENDING.
- WHERE STORAGE FACILITIES SUCH AS CABINETS, SHELVES, CLOSETS AND DRAWERS ARE PROVIDED AT LEAST ONE TYPE PROVIDED SHALL CONTAIN STORAGE SPACE COMPLYING WITH THE FOLLOWING: DOORS TO SUCH SPACES SHALL BE ACCESSIBLE (I.E. TONG LATCHES, U-SHAPED PULLS). SPACES SHALL BE 15 INCHES MINIMUM AND 48 INCHES MAXIMUM ABOVE THE FLOOR FOR FORWARD REACH OR SIDE REACH. CLOTHES HOOKS OR COAT HOOKS SHALL BE A MAXIMUM OF 48 INCHES ABOVE THE FLOOR (46 INCHES MAXIMUM WHEN DISTANCE FROM WHEEL CHAIR TO HOOK EXCEEDS 10 INCHES). SHELVES IN KITCHENS OR TOILET ROOMS SHALL BE 40 INCHES MINIMUM AND 48 INCHES MAXIMUM ABOVE FLOOR.
- CONTROLS, DISPENSERS, RECEPTACLES AND OTHER OPERABLE EQUIPMENT SHALL BE NO HIGHER THAN 48 INCHES ABOVE THE FLOOR. RECEPTACLES ON WALLS SHALL BE MOUNTED NO LESS THAN 15 INCHES ABOVE THE FLOOR. EXCEPTION: HEIGHT LIMITATIONS DO NOT APPLY WHERE THE USE OF SPECIAL EQUIPMENT DICTATES OTHERWISE OR WHERE ELECTRICAL RECEPTACLES ARE NOT NORMALLY INTENDED FOR USE BY BUILDING OCCUPANTS.
- WHERE EMERGENCY WARNING SYSTEMS ARE PROVIDED, THEY SHALL INCLUDE BOTH AUDIBLE AND VISUAL ALARMS. THE VISUAL ALARMS SHALL BE LOCATED THROUGHOUT, INCLUDING RESTROOM, AND PLACED 80 INCHES ABOVE THE FLOOR OR 6 INCHES BELOW CEILING, WHICH EVER IS LOWER.
- ALL DOORS SHALL BE OPERABLE BY A SINGLE EFFORT. DOOR CLOSERS SHALL BE ADJUSTED SO THAT FROM AN OPEN POSITION OF 90 DEGREES, THE TIME REQUIRED TO MOVE THE DOOR TO AN OPEN POSITION OF 12 DEGREES SHALL BE 5 SECONDS MINIMUM. THE MAXIMUM FORCE REQUIRED FOR PUSHING OR PULLING OPEN DOORS OTHER THAN FIRE DOORS SHALL NOT EXCEED 5 LBS. FOR ALL SLIDING, FOLDING, AND INTERIOR HINGED DOORS.
- FLOOR SURFACES SHALL BE STABLE, FIRM, AND SLIP-RESISTANT. CHANGES IN LEVEL BETWEEN 0.25 INCH AND 0.5 INCH SHALL BE BEVELLED WITH A SLOPE NO GREATER THAN 1:2. CHANGES IN LEVEL GREATER THAN 0.5 INCH REQUIRE RAMPS. CARPET PILE THICKNESS SHALL BE 0.5 MAX. GRABBINGS IN FLOOR SHALL HAVE SPACES NO GREATER THAN 0.5 INCH WIDE IN ONE DIRECTION. DOORWAY THRESHOLDS SHALL NOT EXCEED 0.5 INCH IN HEIGHT.
- ACCESSIBLE WATER CLOSETS SHALL BE 17 INCHES TO 19 INCHES, MEASURED FROM THE FLOOR TO THE TOP OF THE SEAT. GRAB BARS SHALL BE 36 INCHES LONG MINIMUM WHEN LOCATED BEHIND WATER CLOSET AND 40 INCHES MINIMUM WHEN LOCATED ALONG SIDE OF WATER CLOSET, AND SHALL BE MOUNTED 33 INCHES TO 36 INCHES ABOVE THE FLOOR, IN ADDITION.
- ACCESSIBLE URINALS SHALL BE STALL-TYPE OR WALL HUNG WITH ELONGATED RIMS AT A MAXIMUM OF 17 INCHES ABOVE THE FLOOR.
- ACCESSIBLE LAVATORIES AND SINKS SHALL BE MOUNTED WITH THE RIM NO HIGHER THAN 34 INCHES ABOVE THE FLOOR. KNEE CLEARANCE OF AT LEAST 27 INCHES HIGH MUST BE PROVIDED WITH A MINIMUM DEPTH OF 8 INCHES BENEATH THE FIXTURE, AND 9 INCHES HIGH MINIMUM WITH A MINIMUM DEPTH OF 11 INCHES BENEATH THE FIXTURE. THE KNEE SPACE MUST BE AT LEAST 30 INCHES WIDE.
- HOT WATER AND DRAIN PIPES UNDER ACCESSIBLE LAVATORIES AND SINKS SHALL BE INSULATED OR OTHERWISE CONFIGURED TO PROTECT AGAINST CONTACT, INSULATION OR PROTECTION MATERIALS MAY BE SITE INSTALLED. THERE SHALL BE NO SHARP OR ABRASIVE SURFACES UNDER ACCESSIBLE LAVATORIES AND SINKS.
- ACCESSIBLE LAVATORIES AND SINKS SHALL HAVE ACCESSIBLE FAUCETS (I.E. LEVER-OPERATED, PUSH TYPE, ELECTRONICALLY CONTROLLED).
- MIRRORS LOCATED ABOVE LAVATORIES, SINKS OR COUNTERTOPS SHALL BE MOUNTED WITH THE BOTTOM EDGE OF THE REFLECTING SURFACE A MAXIMUM OF 40 INCHES ABOVE THE FLOOR. OTHER MIRRORS IN TOILET ROOMS SHALL BE MOUNTED WITH THE BOTTOM EDGE OF THE REFLECTING SURFACE 35 INCHES MAXIMUM ABOVE THE FLOOR.
- GRAB BARS HAVING A CIRCULAR CROSS SECTION SHALL HAVE AN OUTSIDE DIAMETER OF 1.25 INCHES MINIMUM AND 2.0 INCHES MAXIMUM. THE SPACE BETWEEN THE GRAB BAR AND THE WALL SHALL BE 1.5 INCHES.
- WATER CLOSET FLUSH CONTROL SHALL BE INSTALLED A MAXIMUM OF 36 INCHES ABOVE THE FLOOR AND SHALL BE LOCATED ON THE OPEN SIDE OF THE WATER CLOSET.
- DOORS TO ALL ACCESSIBLE SPACES SHALL HAVE ACCESSIBLE HARDWARE (I.E. LEVER OR OPERATED, PUSH/TYPE, U-SHAPED) MOUNTED WITH OPERABLE PARTS BETWEEN 34 INCHES MINIMUM AND 48 INCHES MAXIMUM ABOVE THE FLOOR.
- TOILET STALL DOORS SHALL BE THE SELF-CLOSING TYPE.
- A TOWEL DISPENSER SHALL BE LOCATED ADJACENT TO ALL ACCESSIBLE LAVATORIES.

ATTENTION LOCAL INSPECTIONS DEPARTMENT
SITE INSTALLED ITEMS

THE FOLLOWING ITEMS HAVE NOT BEEN COMPLETED BY THE MANUFACTURER. HAVE NOT BEEN INSPECTED BY EMC AND ARE NOT CERTIFIED BY THE STATE MODULAR LABEL. NOTE THAT THIS LIST DOES NOT NECESSARILY LIMIT THE ITEMS OF WORK AND MATERIAL THAT MAY BE REQUIRED FOR A COMPLETE INSTALLATION. ALL SITE RELATED ITEMS ARE SUBJECT TO LOCAL JURISDICTION APPROVAL. CODE COMPLIANCE MUST BE DETERMINED AT THE LOCAL LEVEL.

- THE COMPLETE FOUNDATION SUPPORT AND THE DOWN SYSTEM.
- RAMPS, STAIRS AND GENERAL ACCESS TO THE BUILDING.
- PORTABLE FIRE EXTINGUISHER(S)
- BUILDING DRAINS, CLEANOUTS
- AND HOOK-UP TO PLUMBING SYSTEM
- ELECTRICAL SERVICE HOOK-UP (INCLUDING FEEDERS) TO THE BUILDING.
- THE MAIN ELECTRICAL PANEL AND SUB-FEEDERS
- CONNECTION OF ELECTRICAL CIRCUITS CROSSING OVER MODULE MATELINES) - (MIL-IT-UNITS ONLY)
- STRUCTURAL AND AESTHETIC INTERCONNECTIONS BETWEEN MODULES (MIL-IT-UNITS ONLY)
- FIRE INSPECTION
- GLAZED OPENING PROTECTION (SEE GENERAL NOTE NO. 8)
- SPRINKLER SYSTEM
- LAB SINK

BUILDING DESIGN PARAMETERS

1. USE/OCCUPANCY:	BUSINESS
2. CONSTRUCTION TYPE:	VB
3. SPRINKLER SYSTEM:	YES
4. BUILDING AREA:	15488 S.F.
5. BUILDING HEIGHT:	≤ 15 FEET
6. NUMBER OF STORIES:	1
7. NUMBER OF MODULES:	16
8. OCCUPANT LOAD (SL), BASED ON 100 SP/PERSON	
9. EXTERIOR WALL FIRE RATING:	NOT RATED
10. THIS BUILDING MUST BE INSTALLED WITH THE FIRE SEPARATION DISTANCES REQUIRED BY IBC TABLE 602 AND SECTION 705.3.	
11. ENERGY CODE COMPLIANCE: SEE ATTACHED ENERGY CALCULATIONS.	
12. MANUFACTURERS DATA PLATE, STATE LABELS AND EMC LABELS ARE TO BE LOCATED ADJACENT TO ELECTRICAL PANEL.	

ALLOWABLE AREA CALCULATION

OCCUPANCY GROUP:	BUSINESS
CONSTRUCTION TYPE:	VB
TABLE 503 AREA:	9,000 S.F.
300% SPRINKLER INCREASE (506.3)	27,000 S.F.
ALLOWABLE AREA:	36,000 S.F.

APPROVED-STATE OF GEORGIA
INDUSTRIALIZED BUILDINGS PROGRAM
DESIGN APPROVAL AGENCY: EMC

CONST. TYPE	VB
OCCUPANCY	B
FLOOR LL (PSF)	50
WIND VELOCITY (MPH)	130
SEISMIC DESIGN CATEGORY	C
EXTERIOR WALL FIRE RATING (HRS)	0
PLAN NUMBER	4376
APPROVAL DATE	

EMC

CODE SUMMARY:

STATE	BUILDING	ELECTRICAL	MECHANICAL	PLUMBING	ACCESSIBILITY	ENERGY CODE
GEORGIA	2012 IBC W/ 2014 GA. AMEND. CHAPTER 1201-3-3, 2012 LIFE SAFETY CODE.	2011 NEC	2012 IMC W/ 2014 GA. AMEND.	2013 IPC W/ 2014 GA. AMEND.	GA. ACCESS CODE, CHAPTER 1201-3-20, 2010 ADAAG	2009 IECC W/2011 2012 GA. AMENDS.

THE FOLLOWING ITEMS HAVE NOT BEEN COMPLETED BY THE MANUFACTURER. HAVE NOT BEEN INSPECTED BY EMC AND ARE NOT CERTIFIED BY THE STATE MODULAR LABEL. NOTE THAT THIS LIST DOES NOT NECESSARILY LIMIT THE ITEMS OF WORK AND MATERIAL THAT MAY BE REQUIRED FOR A COMPLETE INSTALLATION. ALL SITE RELATED ITEMS ARE SUBJECT TO LOCAL JURISDICTION APPROVAL. CODE COMPLIANCE MUST BE DETERMINED AT THE LOCAL LEVEL.

- THE COMPLETE FOUNDATION SUPPORT AND THE DOWN SYSTEM.
- RAMPS, STAIRS AND GENERAL ACCESS TO THE BUILDING.
- PORTABLE FIRE EXTINGUISHER(S)
- BUILDING DRAINS, CLEANOUTS
- AND HOOK-UP TO PLUMBING SYSTEM
- ELECTRICAL SERVICE HOOK-UP (INCLUDING FEEDERS) TO THE BUILDING.
- THE MAIN ELECTRICAL PANEL AND SUB-FEEDERS
- CONNECTION OF ELECTRICAL CIRCUITS CROSSING OVER MODULE MATELINES) - (MIL-IT-UNITS ONLY)
- STRUCTURAL AND AESTHETIC INTERCONNECTIONS BETWEEN MODULES (MIL-IT-UNITS ONLY)
- FIRE INSPECTION
- GLAZED OPENING PROTECTION (SEE GENERAL NOTE NO. 8)
- SPRINKLER SYSTEM
- LAB SINK

FORT GORDON
REPAIR
CONNELLY HEALTH CLINIC
CONTRACT: M91201-1-13-05-0018-CK
TASK ORDER NO.: MD18-CK18

MANUFACTURER:
SPECIALIZED STRUCTURES INC.
2400 SPRINGHEAD CHURCH ROAD
WILLACOCHEE, GA. 31660
(802) 364-7585

DATE: 9-5-14
SCALE: S1/L1
DEWBY: NO SCALE
JOB NO.: SSA376 A-P
LABELS: EMC
DESTINATION: FORT GORDON
STATE: GEORGIA

COVER SHEET

132 x 120 BUSINESS

1 OF 7

EMC APPROVED
09 18 2014



CONSULTING ARCHITECT
JOHN A. BODZIAK
ARCHITECTURE DESIGN AND CONSTRUCTION MANAGEMENT
STATE REGISTRATION NO. 14007019
1224 UNIVERSITY ROAD
SUITE 1000, GAITHERSBURG, MARYLAND 20878
TEL: (773) 327-0968 FAX: (773) 965-0119

CONSULTING ENGINEER
JAMES BRADLEY, P.E.
PROFESSIONAL ENGINEER
STATE REGISTRATION NO. 14007019
1224 UNIVERSITY ROAD
SUITE 1000, GAITHERSBURG, MARYLAND 20878
TEL: (773) 327-0968 FAX: (773) 965-0119





REV.	REVISION DATE	BY
1	8-26-14	T.L.H.



FORT GORDON
REPAIR
CONNELLY HEALTH CLINIC
 CONTRACT: W912DY-13-D-0018-CX
 TASK ORDER NO.: WD18-0K18

MANUFACTURER:
SPECIALIZED STRUCTURES INC.
 2400 SPRINGHEAD CHURCH ROAD
 WILLACOOCHEE, GA. 31660
 (912) 384-7565

DATE: 9-5-14
DRAWN BY: S.L.H.
SCALE: NO SCALE
JOB NO.: S94376 A-P
LABELS: EAC
DESTINATION: FORT GORDON
STATE: GEORGIA
FLOOR PLAN
 132 x 120 BUSINESS
 2 OF 7

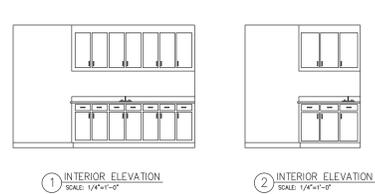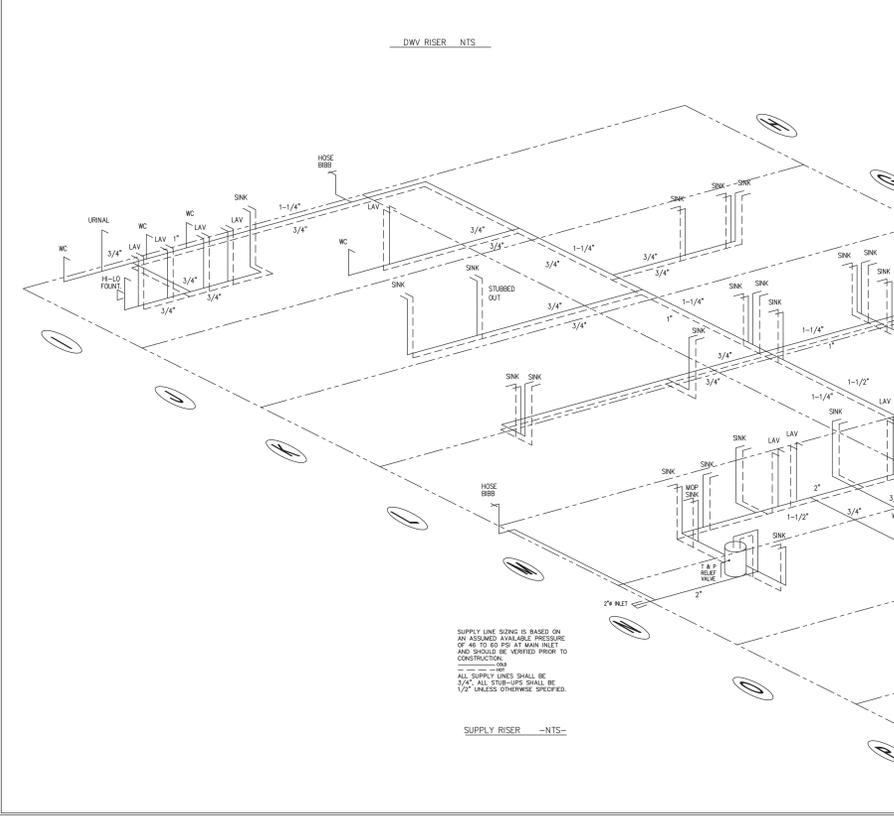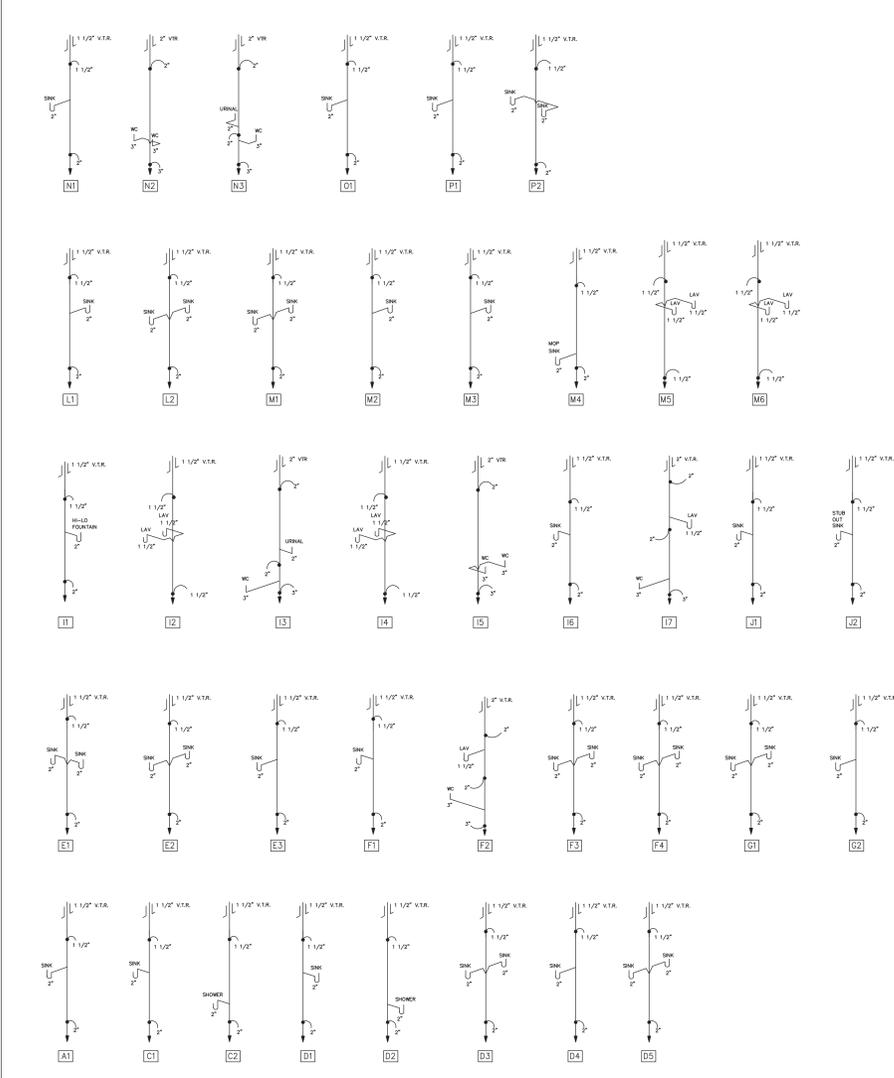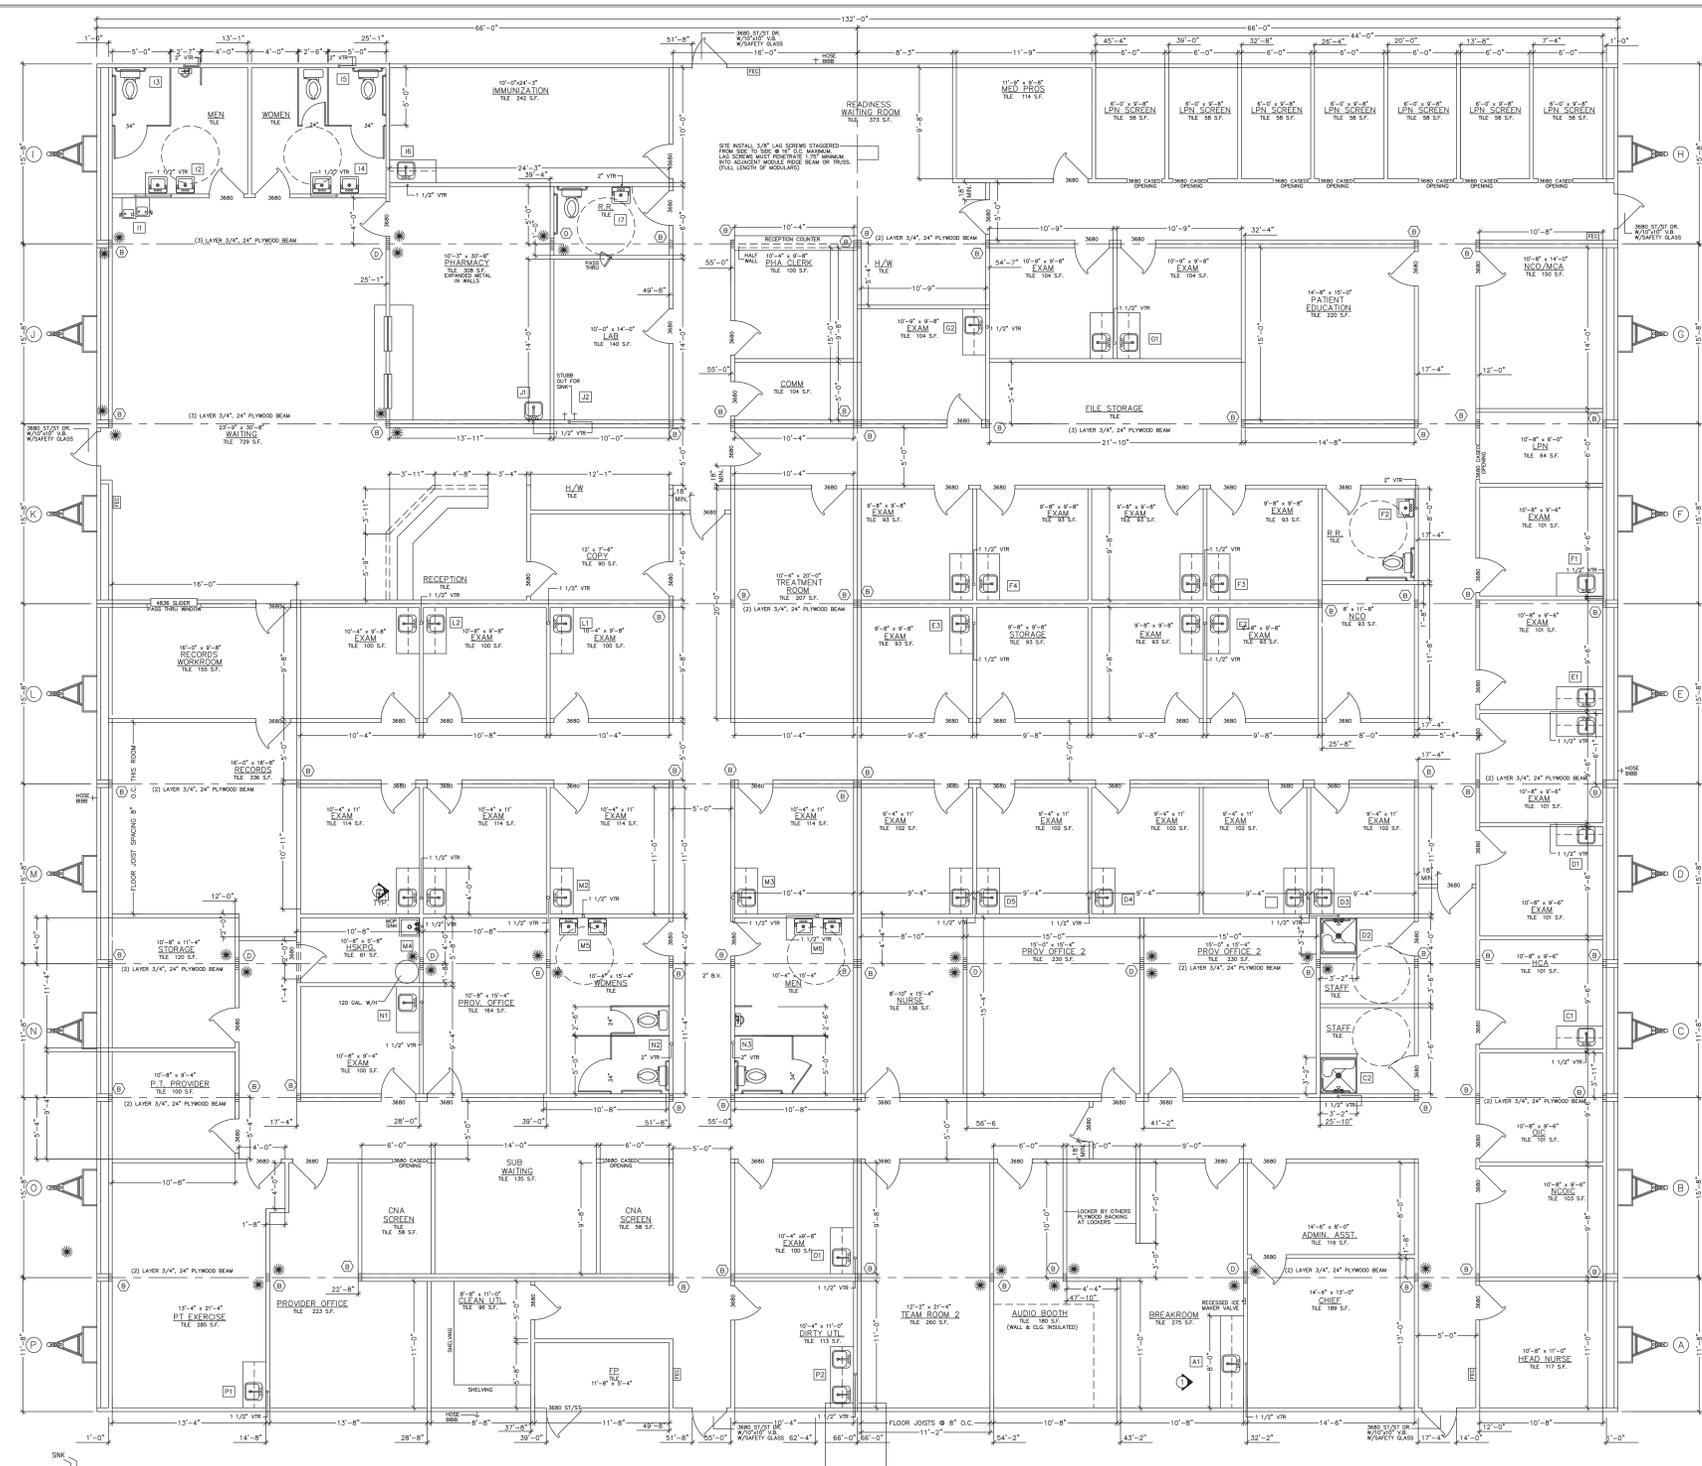


COLUMN STRAPPING SCHEDULE:

(1) 2x4 SPF #2 THIS HALF.	(2) 2x4 SPF #2 EACH HALF.
(3) 2x4 SPF #2 THIS HALF.	(3) 2x4 SPF #2 EACH HALF.
(4) 2x4 SPF #2 THIS HALF.	(4) 2x4 SPF #2 EACH HALF.
(5) 2x4 SPF #2 THIS HALF.	(5) 2x4 SPF #2 EACH HALF.

NOTE: WITH RIDGE BEAM BEARING STIFFENER

ALL COLUMN STUDS SHALL BE GALVANIZED TOGETHER.
 PIVOT GLEYS WITH HOSE COVERAGE SHALL BE USED.
 INSTALL TWO STEEL STRAPS AT EACH STUD OF EACH COLUMN.
 COLUMN STUDS SHALL NOT BE NOTCHED OR BORED.

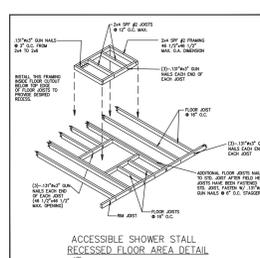

CONSULTING ARCHITECT
JOHN A. BODZIAK
 ARCHITECT AIA, P.A.
 ARCHITECTURAL DESIGN AND CONSTRUCTION MANAGEMENT
 1000 W. BENTLEY BLVD., SUITE 200
 ATLANTA, GEORGIA 30331
 TEL: (770) 332-1986 FAX: (770) 332-5119

CONSULTING ENGINEER
JAMES BRADLEY, P.E.
 ENGINEERING
 1000 W. BENTLEY BLVD., SUITE 200
 ATLANTA, GEORGIA 30331
 TEL: (770) 332-1986 FAX: (770) 332-5119

SUPPLY LINE SIZING IS BASED ON
 AN ASSUMED MINIMUM FLOW RATE
 OF 45 TO 60 GPM AT MAIN INLET
 AND SHOULD BE VERIFIED PRIOR TO
 CONSTRUCTION.
 ALL SUPPLY LINES SHALL BE
 3/4" UNLESS OTHERWISE SPECIFIED.
 1/2" UNLESS OTHERWISE SPECIFIED.

1	8-26-14	T.L.H.
---	---------	--------

NOTES:



**FORT GORDON
REPAIR**
CONNELLY HEALTH CLINIC
CONTRACT: W912DY-13-D-0018-CX
TASK ORDER NO.: WD18-0K18

MANUFACTURER:
SPECIALIZED STRUCTURES INC.
2400 SPRINGHEAD CHURCH ROAD
WILLACOCOCHEE, GA. 31650
(912) 384-7565

DATE: 9-5-14
DRAWN BY: S.L.H.
SCALE: NO SCALE
RIB NO.: SSA376 A-P
DESTINATION: FORT GORDON
STATE: GEORGIA

ELECT PLAN
132 x 120 BUSINESS

3 OF 7

CONSULTING ARCHITECT
JOHN A. BOZDZIK
ARCHITECT, AIA, P.A.
1000 W. BROADWAY, SUITE 200
ATLANTA, GEORGIA 30333
TEL: (404) 261-1888 FAX: (404) 261-1819

CONSULTING ENGINEER
JAMES BRADLEY, P.E.
REGISTERED PROFESSIONAL ELECTRICAL ENGINEER
1000 W. BROADWAY, SUITE 200
ATLANTA, GEORGIA 30333
TEL: (404) 261-1888 FAX: (404) 261-1819

ELECTRICAL SCHEDULE 'J'

SYMBOL	DESCRIPTION	QUANTITY	UNIT	AMPS	WATTAGE	REMARKS
1.3	RECEPTACLE	20	EA	15	270	
1.4	RECEPTACLE	20	EA	15	270	
1.5	RECEPTACLE	20	EA	15	270	
1.6	RECEPTACLE	20	EA	15	270	
1.7	RECEPTACLE	20	EA	15	270	
1.8	RECEPTACLE	20	EA	15	270	
1.9	RECEPTACLE	20	EA	15	270	
1.10	RECEPTACLE	20	EA	15	270	
1.11	RECEPTACLE	20	EA	15	270	
1.12	RECEPTACLE	20	EA	15	270	
1.100	RECEPTACLE	20	EA	15	270	

ELECTRICAL PANEL SIZING:

DESCRIPTION: PANEL 'J' KVA

GENERAL LIGHTING: 2.2
 200 RECEPTACLES AT 150VA/FLOOR: 3.0
 WATER HEATER 1.0 KW X 1.25: 1.25
 (2) FAN(S) AT 3 KW X 1.25: 3.75
 (2) FAN(S): 0.6

TOTAL: 48.8 KW
 TOTAL PANEL LOAD: 180 AMPS
 INSTALL: 200 AMP PANEL
 (2) FAN(S) AT 3 KW X 1.25


NOTE: PANEL BOX TO HAVE LOCK AND BE KEYPED ALIKE

ELECTRICAL SCHEDULE 'L'


SYMBOL	DESCRIPTION	QUANTITY	UNIT	AMPS	WATTAGE	REMARKS
1.3	RECEPTACLE	20	EA	15	270	
1.4	RECEPTACLE	20	EA	15	270	
1.5	RECEPTACLE	20	EA	15	270	
1.6	RECEPTACLE	20	EA	15	270	
1.7	RECEPTACLE	20	EA	15	270	
1.8	RECEPTACLE	20	EA	15	270	
1.9	RECEPTACLE	20	EA	15	270	
1.10	RECEPTACLE	20	EA	15	270	
1.11	RECEPTACLE	20	EA	15	270	
1.12	RECEPTACLE	20	EA	15	270	
REV.	REVISION DATE	BY
1	8-26-14	T.L.H.


NOTES:

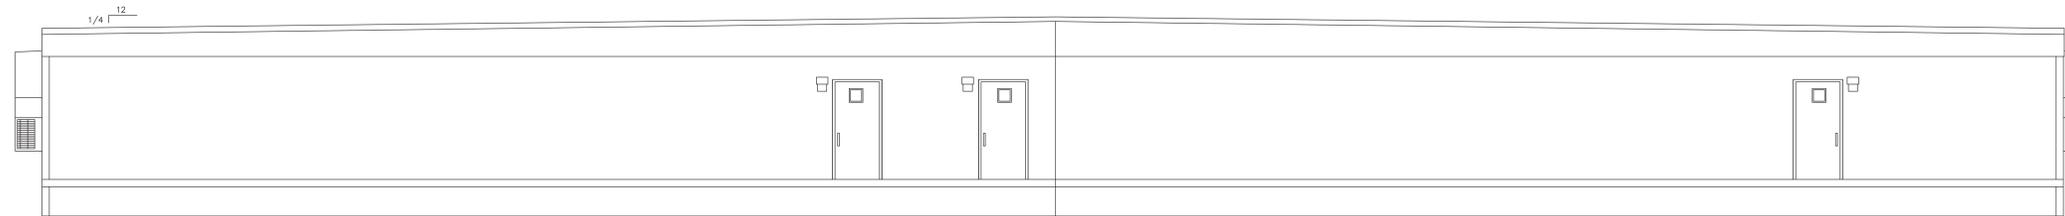


RIGHT ELEVATION

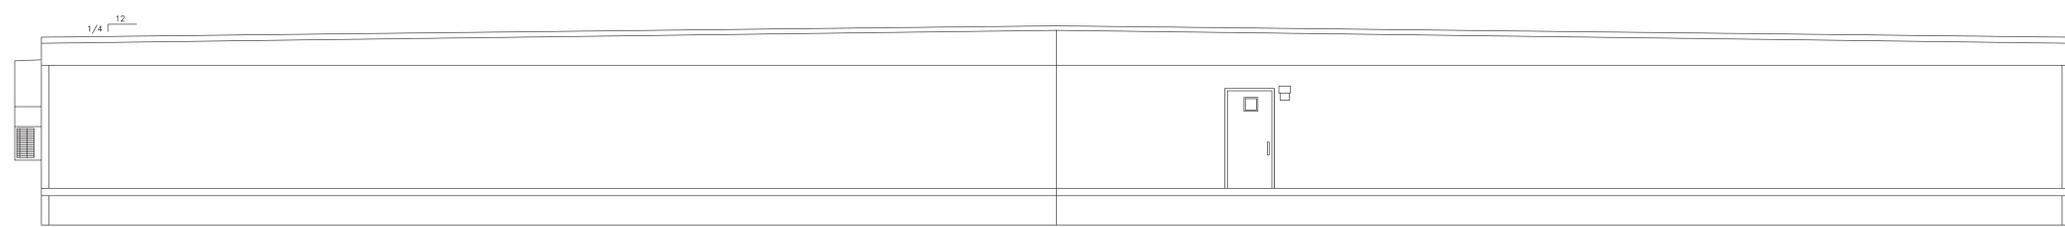

LEFT ELEVATION

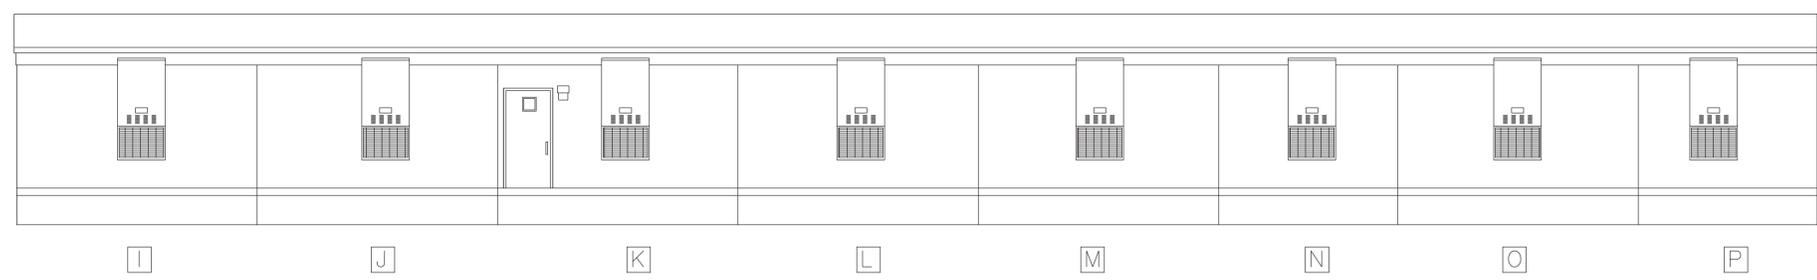

FRONT ELEVATION

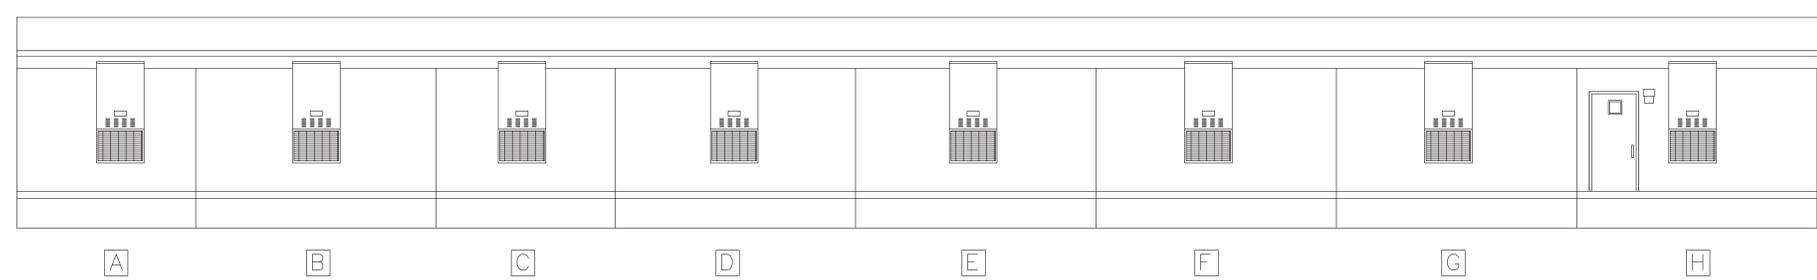

REAR ELEVATION

ELEVATION NOTES: TYPICAL
 SEE-CROSS SECTION FOR METHOD OF ROOF VENTILATION
 ACCESSIBLE RAMP(S), STAIR(S), AND HANDRAILS ARE SITE INSTALLED, DESIGNED BY OTHERS, AND SUBJECT TO LOCAL JURISDICTION.
 FOUNDATION ENCLOSURE (WHEN PROVIDED) MUST HAVE 1 SQUARE FOOT NET VENT AREA PER 1/150TH OF THE FLOOR AREA, AND AN 18" X 24" MINIMUM CRAWL SPACE ACCESS. SITE INSTALLED BY OTHERS SUBJECT TO LOCAL JURISDICTION.

APPROVED
 09 18 2014

FORT GORDON REPAIR
CONNELLY HEALTH CLINIC
 CONTRACT: WB1207-13-01-0018-0K
 TASK: ORDER NO.: WD18-0K18

MANUFACTURER:
 SPECIALIZED STRUCTURES INC.
 2400 SPRINGHEAD CHURCH ROAD
 WILLACOOCHEE, GA. 31650
 (821) 384-7555

DATE: 9-5-14
 DRAWN BY: S.L.H.
 SCALE: NO SCALE
 JOB NO: SS4376 A-P
 LABELS: EMC
 DESTINATION: FORT GORDON
 STATE: GEORGIA

ELEVATIONS

132 x 120 BUSINESS

5 OF 7






CONSULTING ARCHITECT
JOHN A. BODZIAK
 ARCHITECT AIA, P.A.
 ARCHITECTURE, INTERIOR AND CONSTRUCTION MANAGEMENT
 1700 WASHINGTON ROAD, SUITE 200
 WASHINGTON, GEORGIA 30335
 TEL: (770) 237-1988 FAX: (770) 885-5111

CONSULTING ENGINEER
JAMES BRADLEY, P.E.
 PROFESSIONAL ENGINEER
 1700 WASHINGTON ROAD, SUITE 200
 WASHINGTON, GEORGIA 30335
 TEL: (770) 237-1988 FAX: (770) 885-5111

REV.	REVISION DATE	BY
1	8-26-14	T.L.H.

NOTES:

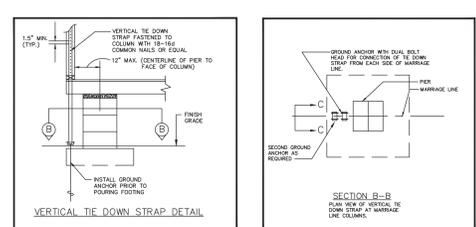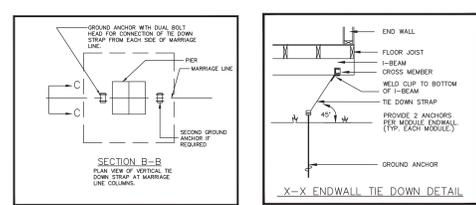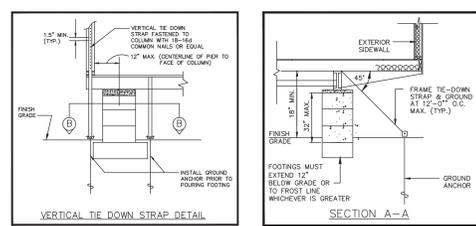

NOTE:
THIS FOUNDATION PLAN IS PROVIDED FOR REFERENCE AS A TYPICAL STANDARD. ACTUAL FOUNDATION CONDITIONS MUST BE EVALUATED FOR APPLICABILITY IF THIS PLAN IS TO BE USED. ALTERNATE FOUNDATION PLANS MAY BE DESIGNED BY OTHERS IN ACCORDANCE WITH THE REQUIREMENTS OF THE JURISDICTION HAVING AUTHORITY.







FOUNDATION NOTES:

- ALL FOUNDATION CONSTRUCTION, MATERIALS, AND INSTALLATION SHALL BE IN ACCORDANCE WITH ALL APPLICABLE STATE AND LOCAL CODES.
- TE-DOWN STRAPS TO BE 1-1/4" x 1/4" x 305" TYPE-1, FINISH B, GRADE 1 ZINC COATED STEEL STRAPPING CERTIFIED BY A REGISTERED ENGINEER OR ARCHITECT AS CONFORMING WITH ASTM D3653-91. TE-DOWN STRAPS AND CONNECTING HARDWARE SHALL HAVE 2700 MINIMUM WORKING CAPACITY.
- GROUND ANCHORS SHALL HAVE 3150# MINIMUM WORKING CAPACITY, AND SHALL BE INSTALLED IN ACCORDANCE WITH THE MANUFACTURER'S SPECIFICATIONS. CENTER OF GROUND ANCHOR, INCLUDING GRADE LENGTH, NUMBER AND DIAMETER OF REBARS, ETC., TO BE AS SPECIFIED BY THE GROUND ANCHOR MANUFACTURER FOR THE ACTUAL SOIL TYPE ENCOUNTERED. IF THE HOLDING OR PULLOUT CAPACITIES OF GROUND ANCHORS ARE BELOW THE VALUES SPECIFIED ABOVE, THE ARCHITECT/ENGINEER MUST BE CONSULTED FOR AN ALTERNATE ANCHORAGE DESIGN.
- THE FIRST TE-DOWN STRAP FROM ENDWALLS SHALL NOT EXCEED 1/2 THE MAXIMUM SPACING INDICATED.
- ALL PIERS SHALL BE CONSTRUCTED OF CONCRETE MASONRY UNITS CONFORMING TO ASTM C90. MASONRY UNITS SHALL BE Laid IN TYPE M OR S MORTAR OR COVERED WITH SURFACE BONDING CEMENT INSTALLED IN ACCORDANCE WITH ITS LISTING. PIER FOOTINGS SHALL BE AS DESCRIBED ABOVE.
- MINIMUM CONCRETE FOOTING COMPRESSIVE STRENGTH 1500 PSI AT 28 DAYS.
- ALL REINFORCEMENT BARS SHALL COMPLY WITH ASTM A615, GRADE 60. REINFORCEMENT BARS SHALL BE EQUALLY SPACED AND PLACED WITH 3" CLEARANCE FROM BOTTOM AND SIDES OF THE FOOTING.
- ALL PIERS SHALL BE CAPPED WITH 2# 51# PRESSURE TREATED SILL PLATES, FULL LENGTH OF PIER.
- I-BEAM SUPPORT PIERS MAY BE INSTALLED LATERALLY (90°) FROM THE ORIENTATION SHOWN ON THE FOUNDATION PLAN. CENTERLINE OF EACH PIER MUST BE LOCATED DIRECTLY BELOW THE I-BEAM CENTERLINE.
- SOIL BEARING CAPACITY SHOWN ON THIS PLAN IS ASSUMED. IF THE ACTUAL SOIL BEARING CAPACITY IS LESS THAN 2000 PSF, THE ARCHITECT/ENGINEER MUST BE CONSULTED FOR REQUIRED ALTERNATE FOUNDATION DESIGN. FOOTINGS SHALL BE PLACED ON NON-EXPANSIVE SOILS ONLY.
- INSTALL BLOCK PIER ON EACH SIDE OF ALL EXTERIOR DOOR OPENINGS. MANUFACTURER'S RECOMMENDATION (ONLY - OPTIONAL WHEN NOT SHOWN) SLIGHT ADJUSTMENT MAY BE REQUIRED TO INSURE OPENABILITY AFTER INSTALLATION OF BUILDING IS COMPLETE.
- THE AREA UNDER FOOTINGS AND FOUNDATIONS SHALL HAVE ALL VEGETATION, STUMPS, ROOTS, AND FOREIGN MATERIALS REMOVED PRIOR TO THEIR CONSTRUCTION.
- THE FOUNDATION DIMENSIONS SHOWN ARE NOMINAL. AN INCREASE IN MODULE WIDTH SHOULD BE EXPECTED DUE TO MODULE EXPANSION, SETTING TOLERANCES, ETC. THE FOUNDATION CONTRACTOR SHOULD CONSULT WITH THE MANUFACTURER OF THE MODULES PRIOR TO CONSTRUCTION OF THE FOUNDATION TO DETERMINE THE AMOUNT OF INCREASED WIDTH TO BE ADDED TO THE NOMINAL DIMENSIONS SHOWN ABOVE.

NOTE:
THE NUMBER OF PIERS SHOWN ON THIS FOUNDATION PLAN IS NO INDICATION OF THE AMOUNT OF PIERS REQUIRED AND NEEDED FOR THIS BUILDING. SEE MAXIMUM PIER SPACING CHART BELOW FOR THE CORRECT NUMBER OF PIERS REQUIRED FOR EACH SOIL BEARING CAPACITY.

FOUNDATION DIMENSIONS		
A	B	C
MODULE WIDTH	PIER TO MODULE EDGE	STEEL BEAM SPACING
11'-8"	22 1/4"	95 1/2"
D	MAXIMUM PIER SPACING	MINIMUM SOIL BEARING CAPACITY
5'-0"	8'-0"	2000 PSF 3000 PSF

FOUNDATION DIMENSIONS		
A	B	C
MODULE WIDTH	PIER TO MODULE EDGE	STEEL BEAM SPACING
15'-8"	46 1/4"	95 1/2"
D	MAXIMUM PIER SPACING	MINIMUM SOIL BEARING CAPACITY
5'-0"	8'-0"	2000 PSF 3000 PSF

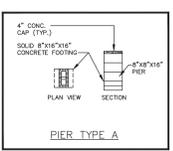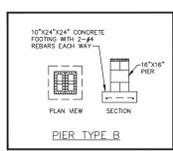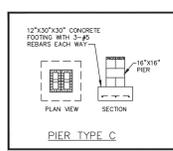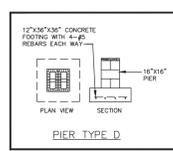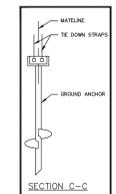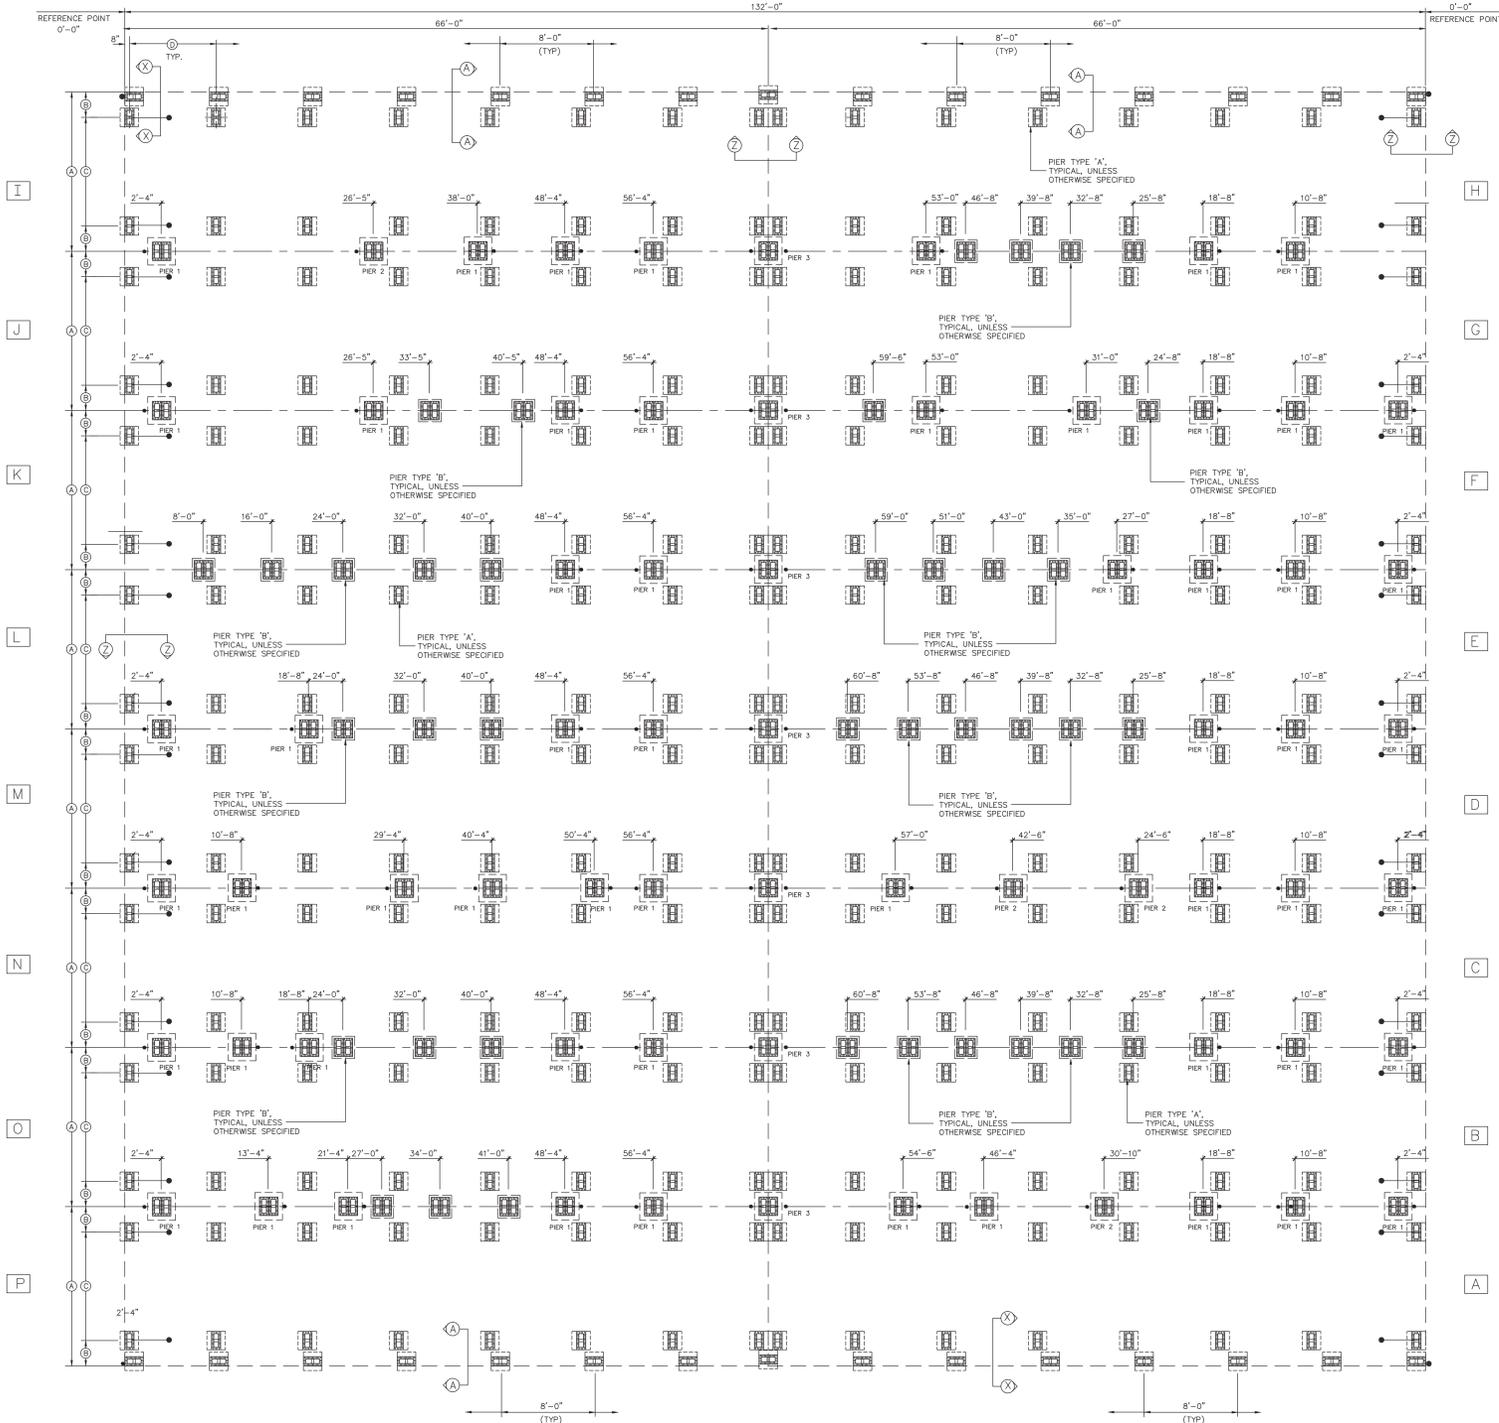

MARRIAGE WALL PIER REQUIREMENTS

PIER NUMBER	MINIMUM SOIL BEARING CAPACITY	PIER TYPE	NUMBER OF VERTICAL TIE-DOWN STRAPS (REQD. EACH MODULE)
1	2000 PSF	B	1
2	3000 PSF	C	1
3	2000 PSF	B	2
	3000 PSF	B	2



CONSULTING ARCHITECT
JOHN A. BODZIAK
ARCHITECT AIA, P.A.
ARCHITECTURE, DESIGN AND CONSTRUCTION MANAGEMENT
GEORGIA REGISTRATION NO. 2402759
MEMBER - PROFESSIONAL BOARD
DATE 3/22/2014 BY TERRY BROWN

CONSULTING ENGINEER
JAMES BRADLEY, P.E.
REGISTERED PROFESSIONAL ENGINEER
MEMBER - PROFESSIONAL BOARD
DATE 3/22/2014 BY TERRY BROWN

FORT GORDON
REPAIR
CONNELLY HEALTH CLINIC
CONTRACT: W9720T-13-D-0018-CX
TASK ORDER NO.: WD18-CK16

MANUFACTURER:
SPECIALIZED STRUCTURES INC.
2400 SPRINGHEAD CHURCH ROAD
WILLACOCOCHEE, GA. 31650
(912) 384-7565

FOUNDATION
132 x 120 BUSINESS

